

B-1425-6-SM-ELIZABETH · BENCHES

Bench 1425-6-SM-ELIZABETH



STANDARD CONFIGURATION

Dimensions configured to order.

MATERIALS & CONSTRUCTION

- Laser-cut and formed steel, fully welded.
- Fabricated under one roof in Roanoke, Virginia.
- Multi-stage marine-grade powder-coat finish.

BUILT TO ORDER


Every model is a starting point. Modify size, finish, mounting, and branding to suit the site.

CUSTOMIZE

- | | |
|-----------------|--|
| Size | Lengths, depths, and back height built to the dimension you specify. |
| Finish | Any powder-coat color, standard or custom match. |
| Mounting | Surface, in-ground, or freestanding. |
| Branding | Laser-cut logos, plaques, and donor recognition integrated into the piece. |


WARRANTY

Frame warranted against structural defect; powder-coat finish warranted against failure under normal public-realm use. Full terms on request.

Sales Order: 13460-F	Bench with Custom Logo	Date 4/8/24	
Item: n/a	№ B-1425-6-SM-Elizabeth	Scale N.T.S	
Finish: Primer & Powder Coat, color to be approved	<input type="checkbox"/> approved <input type="checkbox"/> approved as noted <input type="checkbox"/> not approved revise as noted		
PHONE 540.342.1548 FAX 540.342.1417 WEB RCLFINC.COM			

* revised based on feed back from layout options_MC - 04.17.24
 * revised club to group, enlarged apostrophe in women's_MC - 04.24.24

Front View

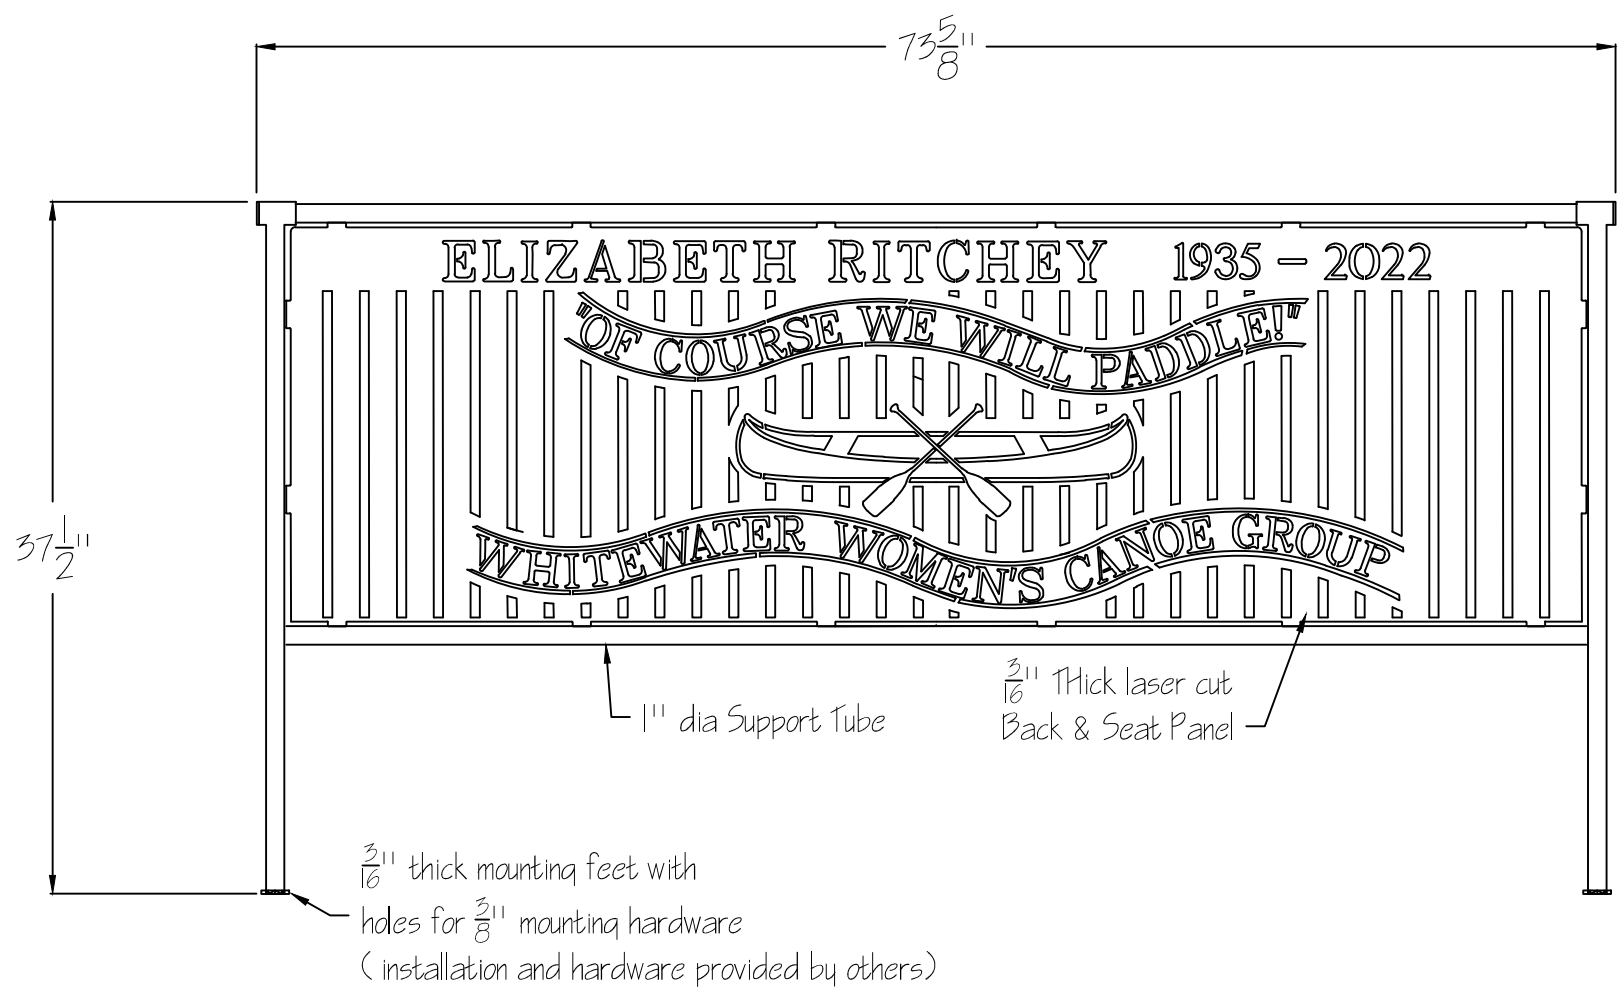

Side View

