

B-1453-CS-6-SM-VA DFS · BENCHES

Government-Branded Bench



STANDARD CONFIGURATION

Dimensions configured to order.

MATERIALS & CONSTRUCTION

- Laser-cut and formed steel, fully welded.
- Fabricated under one roof in Roanoke, Virginia.
- Multi-stage marine-grade powder-coat finish.

BUILT TO ORDER

Every model is a starting point. Modify size, finish, mounting, and branding to suit the site.

CUSTOMIZE

- | | |
|-----------------|--|
| Size | Lengths, depths, and back height built to the dimension you specify. |
| Finish | Any powder-coat color, standard or custom match. |
| Mounting | Surface, in-ground, or freestanding. |
| Branding | Laser-cut logos, plaques, and donor recognition integrated into the piece. |

WARRANTY

Frame warranted against structural defect; powder-coat finish warranted against failure under normal public-realm use. Full terms on request.




Sales Order: 14420-F	6' Curved Bench with DFS Logo	Date: 07.21.26	☐ approved ☐ approved as noted ☐ not approved revise as noted
Item: OF-8	No. B-1453-CS-6-SM-VA DFS	Scale: NTS	
PHONE 540.342.1548 FAX 540.342.1417 WEB RCLFING.COM	Primary Finish: Primer Base with Black Texture Powder Coat Logo: Primer Base with Red Powder Coat (to be approved)		




Approved by: Anna Shronce
SFCS
8/12/2026


Top View

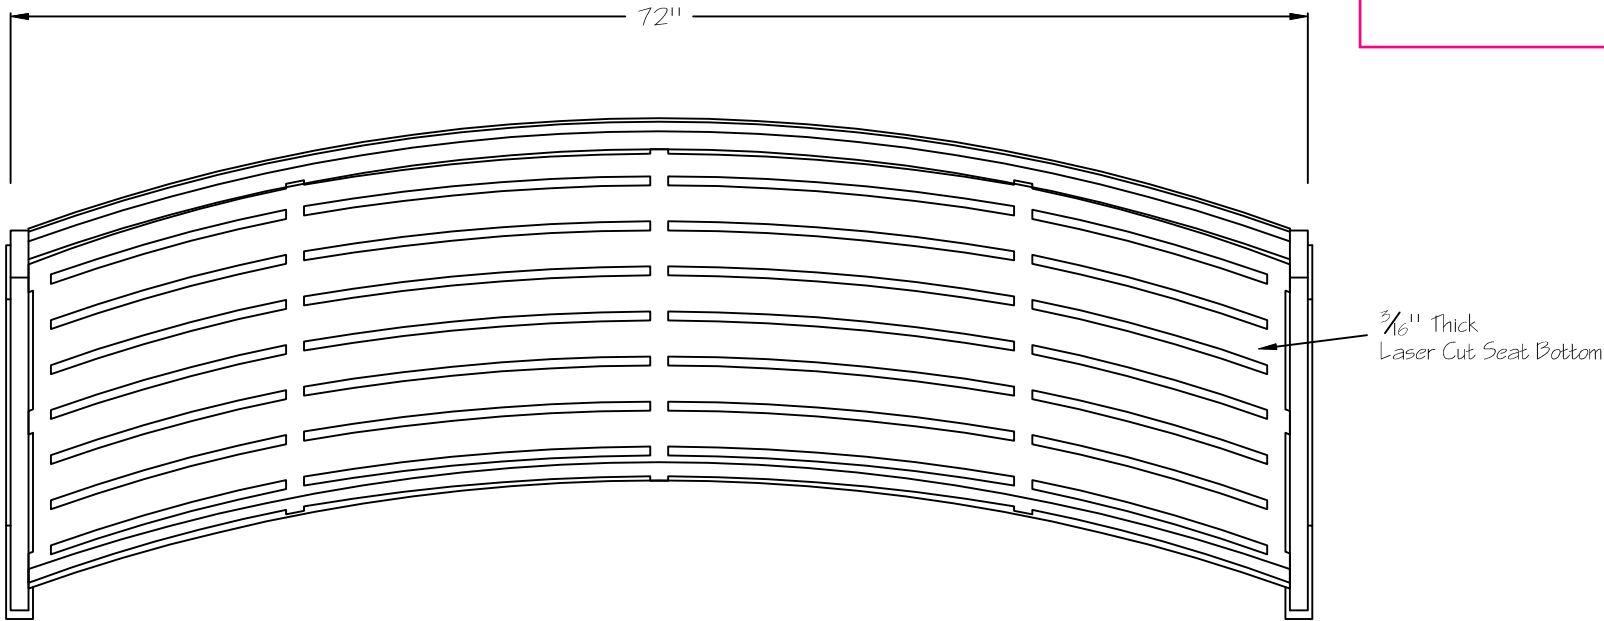

Front View

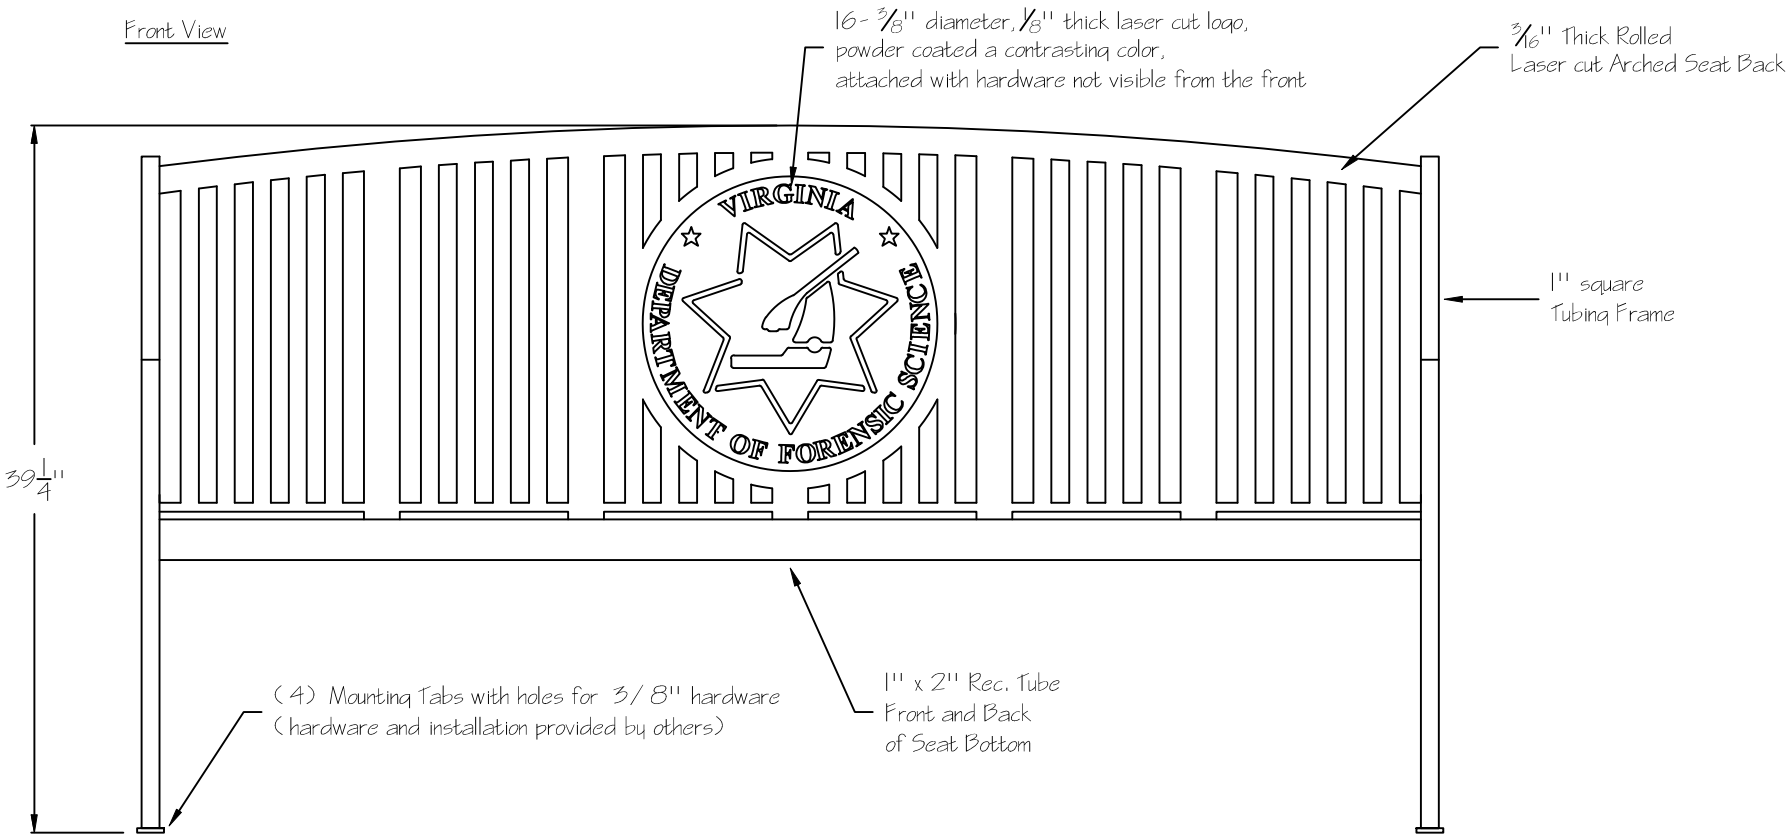

Side View

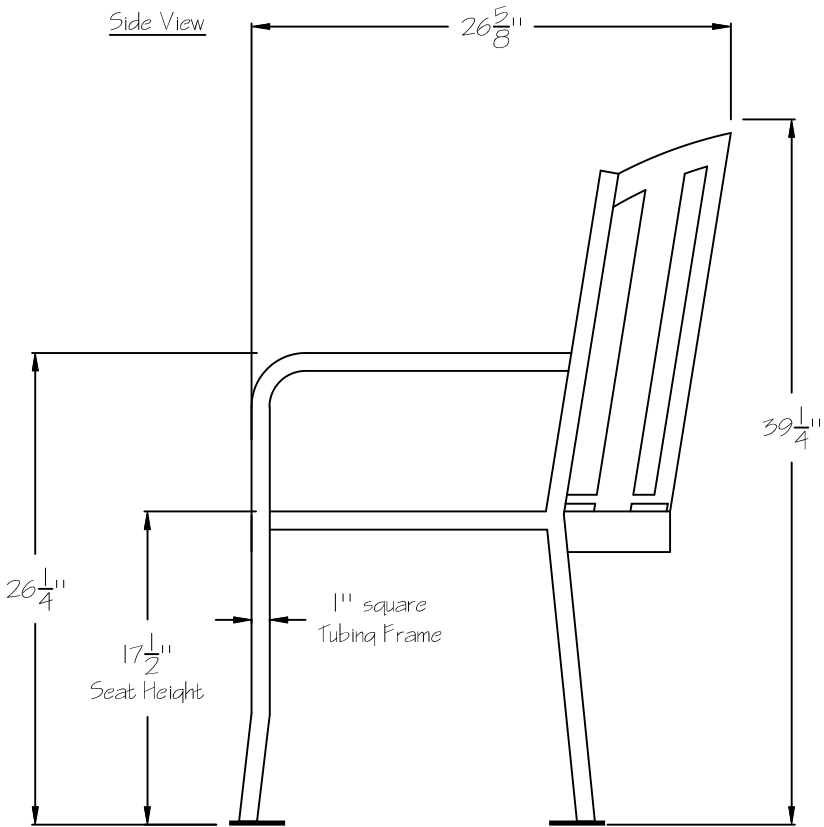



Sales Order: 14420-F	6' Bench with DFS Logo	Date: 07.21.26	☐ approved ☐ approved as noted ☐ not approved revise as noted
Item: OF-4	No. B-1452-CS-6-SM-VA DFS	Scale: NTS	
PHONE 540.342.1548 FAX 540.342.1417 WEB RCLFING.COM	Primary Finish: Primer Base with Black Texture Powder Coat Logo: Primer Base with Red Powder Coat (to be approved)		

Reviewed by: Anna Shronce
SFCS
8/12/2026

