



Sales Order: 11808-L	Custom Picnic Table	
Item: SE-001	No: RF-B-0506-5-SM	
Finish: RAL 9011 Graphite Black	<input type="checkbox"/> approved	Date 5/11/21
Other: n/a	<input type="checkbox"/> approved as noted	BY MBC
	<input type="checkbox"/> not approved revise as noted	Scale NTS
PHONE: 540.342.1548	FAX: 540.342.1417	WEB: RCLFING.COM




Renaissance reserves the right to make adjustments during fabrication to ensure product integrity, performance, and meet applicable UL standards.

Renaissance recommends a "controlled climate" environment whenever prolonged storage is required. Failure to do so will void any / all expressed or implied warranties.


\* revised seat height from 13-3/4" to 16" per redline drawings\_MC - 05.28.21

Top View

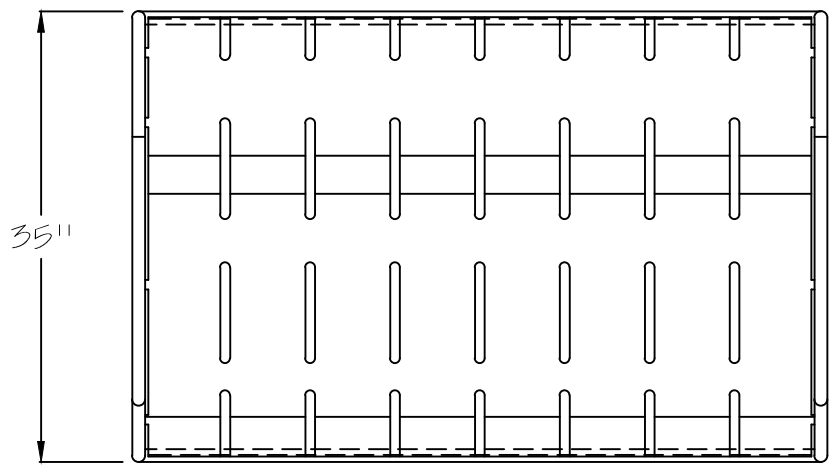


Seat slopes back at 4°  
 Seat depth deeper than standard depths based on inspiration picture.  
 Customer / designer to confirm design and depth.


Front View

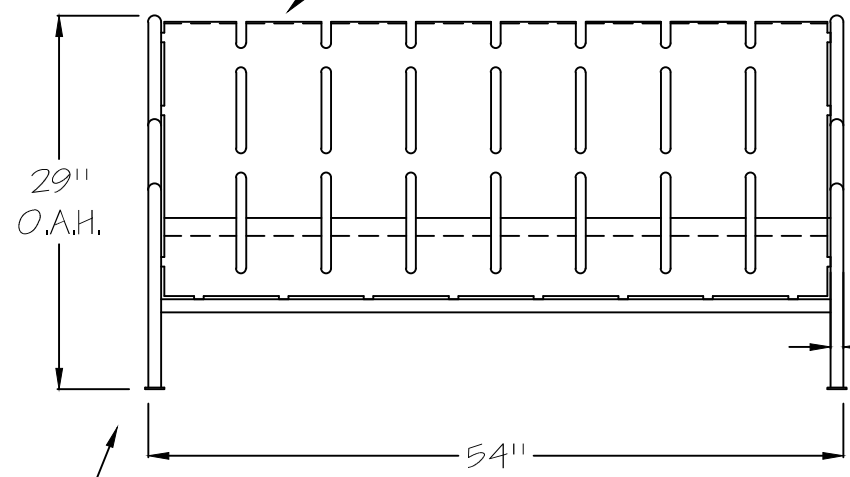

Side View

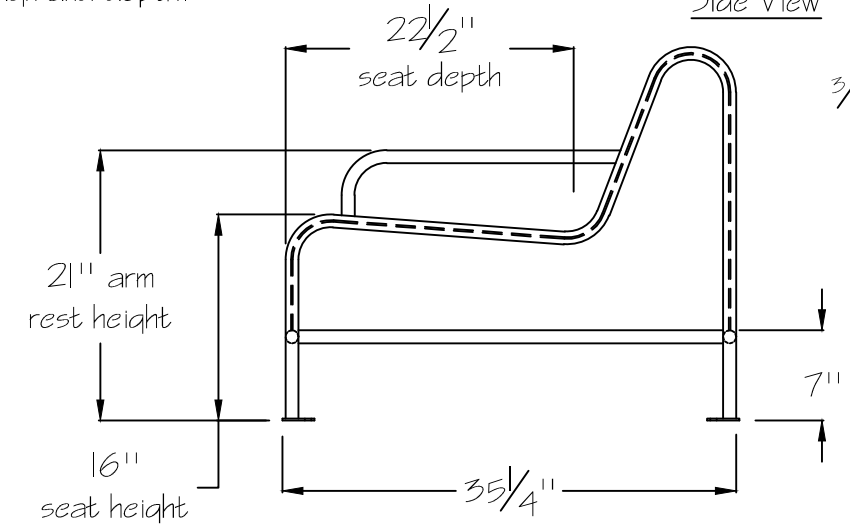

Front View

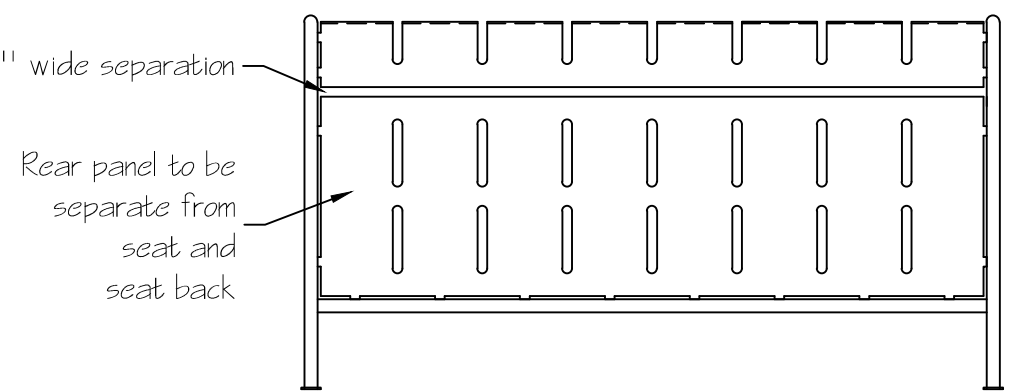

laser cut mounting feet with holes for 1/2" mounting hardware (installation and hardware provided by others)

1" dia tubing frame and arm rest