

RF-B-0506-ADPRINT · BENCHES

Bench 0506-ADPRINT



STANDARD CONFIGURATION

Dimensions configured to order.

MATERIALS & CONSTRUCTION

- Laser-cut and formed steel, fully welded.
- Fabricated under one roof in Roanoke, Virginia.
- Multi-stage marine-grade powder-coat finish.

BUILT TO ORDER

Every model is a starting point. Modify size, finish, mounting, and branding to suit the site.

CUSTOMIZE

- Size** Lengths, depths, and back height built to the dimension you specify.
- Finish** Any powder-coat color, standard or custom match.
- Mounting** Surface, in-ground, or freestanding.
- Branding** Laser-cut logos, plaques, and donor recognition integrated into the piece.

WARRANTY

Frame warranted against structural defect; powder-coat finish warranted against failure under normal public-realm use. Full terms on request.

Sales Order: 11808-L	Custom Picnic Table	
Item: SE-001	No: RF-B-0506-5-SM	
Finish: RAL 9011 Graphite Black	<input type="checkbox"/> approved	Date 5/11/21
Other: n/a	<input type="checkbox"/> approved as noted	BY MBC
	<input type="checkbox"/> not approved revise as noted	Scale NTS
PHONE: 540.342.1548	FAX: 540.342.1417	WEB: RCLFING.COM




Renaissance reserves the right to make adjustments during fabrication to ensure product integrity, performance, and meet applicable UL standards.


Renaissance recommends a "controlled climate" environment whenever prolonged storage is required. Failure to do so will void any / all expressed or implied warranties.

* revised seat height from 13-3/4" to 16" per redline drawings_MC - 05.28.21

Top View

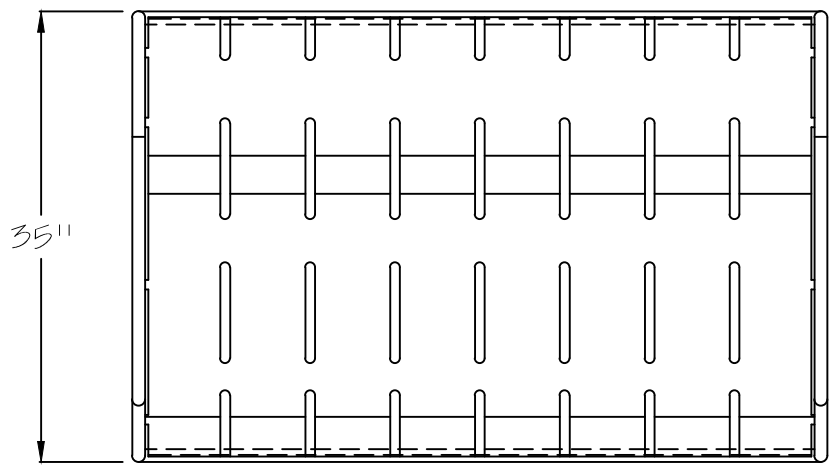


Front View

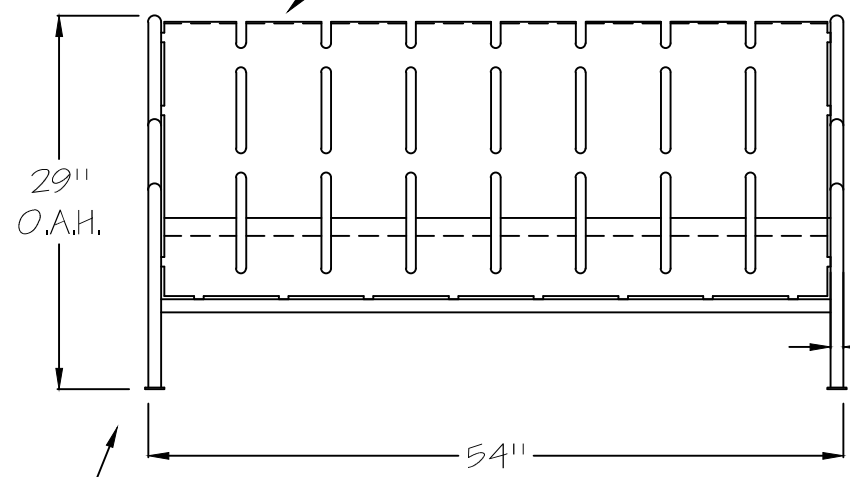


Seat slopes back at 4°
 Seat depth deeper than standard depths based on inspiration picture.
 Customer / designer to confirm design and depth.

Side View

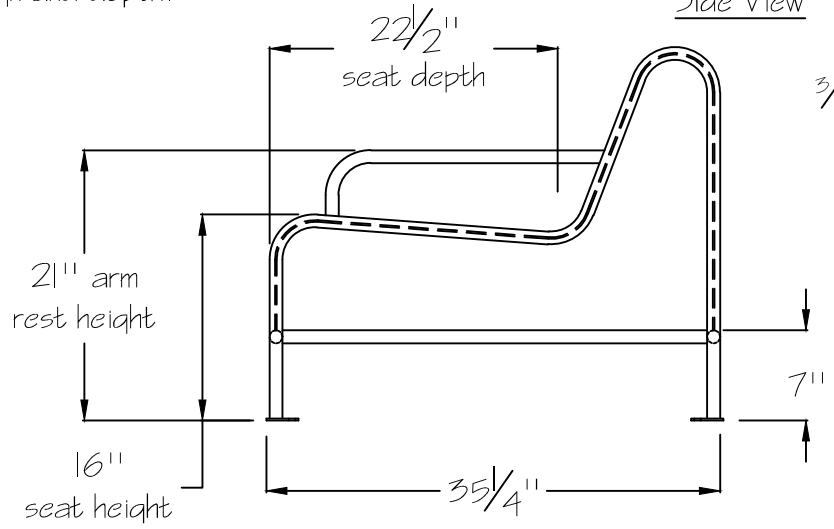

Front View

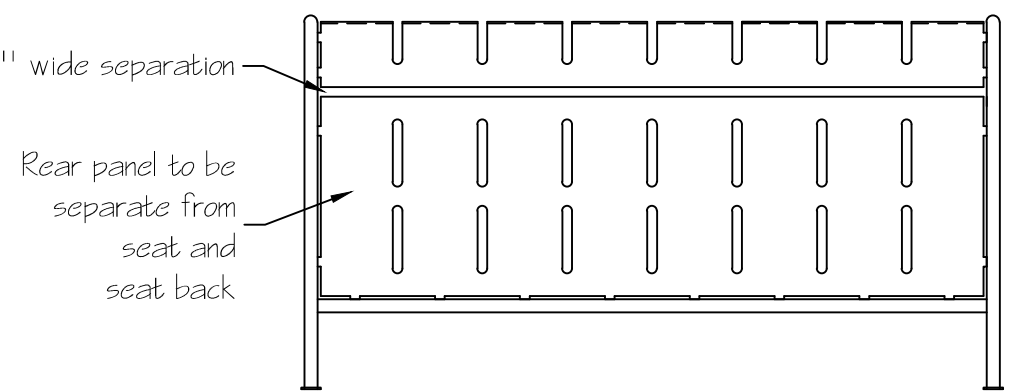

laser cut mounting feet with holes for 1/2 inch mounting hardware (installation and hardware provided by others)

1 inch dia tubing frame and arm rest