B-1425-6-SM-ELIZABETH · BENCHES

Bench 1425-6-SM-ELIZABETH



STANDARD CONFIGURATION

Dimensions configured to order.

MATERIALS & CONSTRUCTION

- Laser-cut and formed steel, fully welded.
- Fabricated under one roof in Roanoke, Virginia.
- Multi-stage marine-grade powder-coat finish.

BUILT TO ORDER

Every model is a starting point. Modify size, finish, mounting, and branding to suit the site.

CUSTOMIZE

Size	Lengths, depths, and back height built to the dimension you specify.
Finish	Any powder-coat color, standard or custom match.
Mounting	Surface, in-ground, or freestanding.
Branding	Laser-cut logos, plaques, and donor recognition integrated into the piece.

WARRANTY

Frame warranted against structural defect; powder-coat finish warranted against failure under normal public-realm use. Full terms on request.

(540) 342-1548 · info@rclfinc.com · Buy America (BABA)


Sales Order: 13460-F	Bench with Custom Logo	Date 4/8/24
Item: n/a	№ B-1425-6-SM-Elizabeth	scale N.T.S
Finish: Primer & Powder Coat, color to be approved	☐ approved ☐ approved as noted ☐ not approved revise as noted	paj

PHONE 540.342.1548 FAX 540.342.1417
WEB RCLFINC.COM

RCLF SITE FURNISHINGS

* revised based on feed back from layout options_MC - 04.17.24
* revised club to group, enlarged apostrophe in women's_MC - 04.24.24

Front View

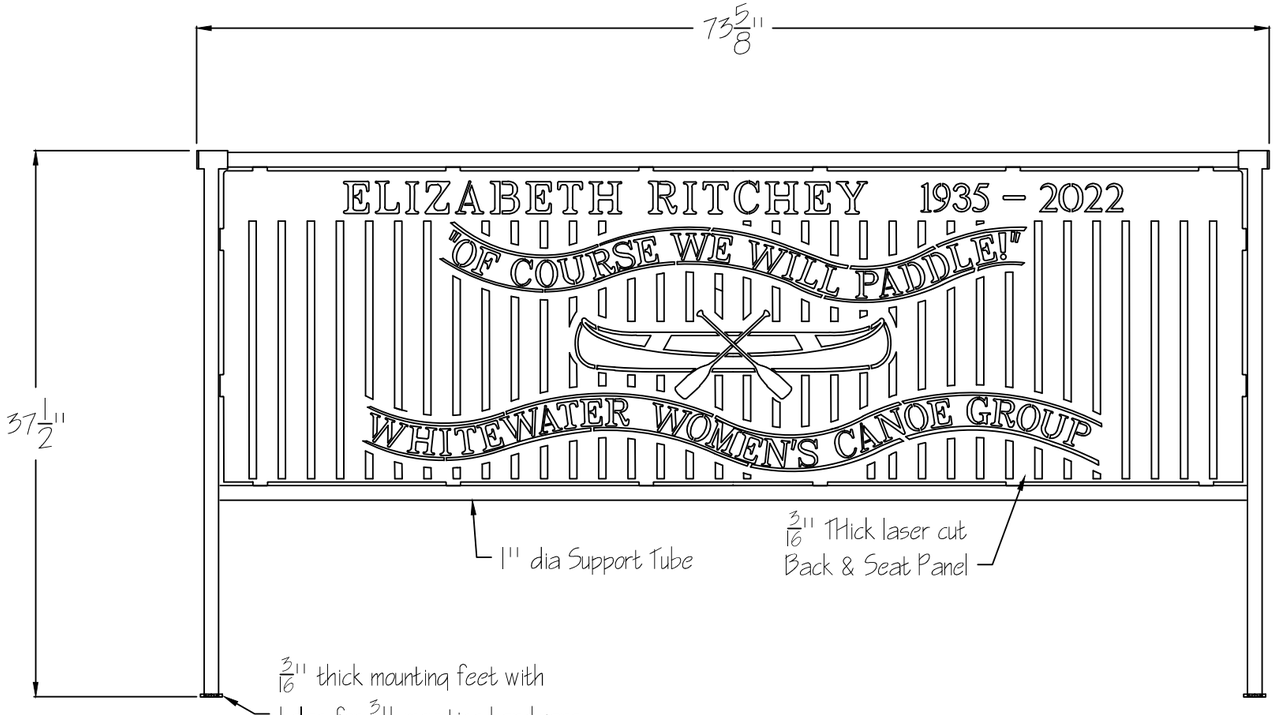

Side View

