RF-B-0506-5-SM · BENCHES

Bench



BUILT TO ORDER

Every model is a starting point. Modify size, finish, mounting, and branding to suit the site.

CUSTOMIZE

Size	Lengths, depths, and back height built to the dimension you specify.
Finish	Any powder-coat color - 33 standard options, plus custom match.
Mounting	Surface mount, Freestanding / portable.
Branding	Laser-cut logos, plaques, and donor recognition integrated into the piece.

STANDARD CONFIGURATION

Dimensions	Dimensions: 54" L x 35.25" D x 29" OAH | RAL 9011 Graphite Black Powder Coat

ANCHORING & ORDER CODES

Surface mount	**RF-B-0506-5-SM-SM**
Freestanding / portable	**RF-B-0506-5-SM-FS**

MATERIALS & CONSTRUCTION

- Laser-cut and formed steel, fully welded.
- Fabricated under one roof in Roanoke, Virginia.
- Multi-stage marine-grade powder-coat finish.

WARRANTY

Frame warranted against structural defect; powder-coat finish warranted against failure under normal public-realm use. Full terms on request.

POWDER-COAT FINISHES

33 standard colors · custom RAL match available

Black Peel	Black Texture	Cappuccino	Cargo Black	Chocolate Brown
Claret-Violet	Classic Grey	Cobalt Blue	Light Ivory	Fence Red
Fir Green	Green-Blue	Gun Metal	Glossy White	Lemon Yellow
Light Blue	Luna	Mineral Bronze	Nut Brown	Olive Patina
Oxblood	Pastel Turquoise	Poly Silver Vein	Red Letter	Rust
Silver Hammerstone	Safety Yellow	Star Dust	Sulfur Yellow	Traffic Gray
Verdi	Water Blue	White Peel		

Sales Order: 11808-L	Custom Picnic Table	
Item: SE-001	No. RF-B-0506-5-SM	
Finish: RAL 9011 Graphite Black	☐ approved	Date 5/11/21
Other: n/a	☐ approved as noted	By MBC
	☐ not approved revise as noted	Scale NTS

PHONE: 540.342.1548 FAX: 540.342.1417 WEB: RCLFINC.COM


RCLF SITE FURNISHINGS

Renaissance reserves the right to make adjustments during fabrication to ensure product integrity, performance, and meet applicable UL standards.


Renaissance recommends a "controlled climate" environment whenever prolonged storage is required. Failure to do so will void any / all expressed or implied warranties.

* revised seat height from 13-¾" to 16" per redline drawings_MC - 05.28.21

Top View

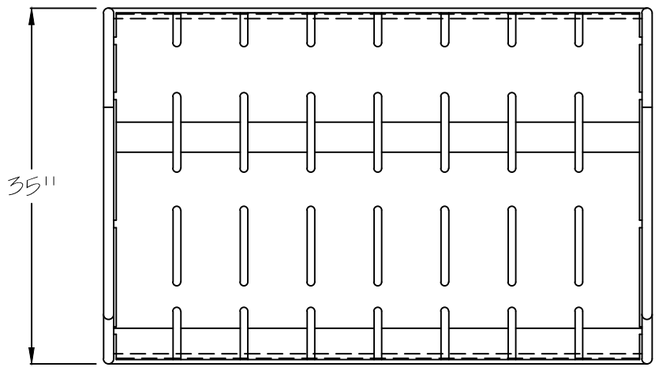


Front View

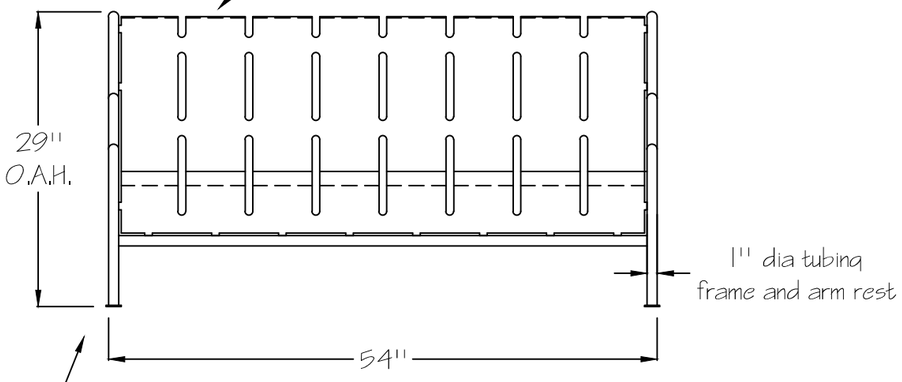

Seat slopes back at 4°
Seat depth deeper than standard depths based on inspiration picture. Customer / designer to confirm design and depth.

Side View

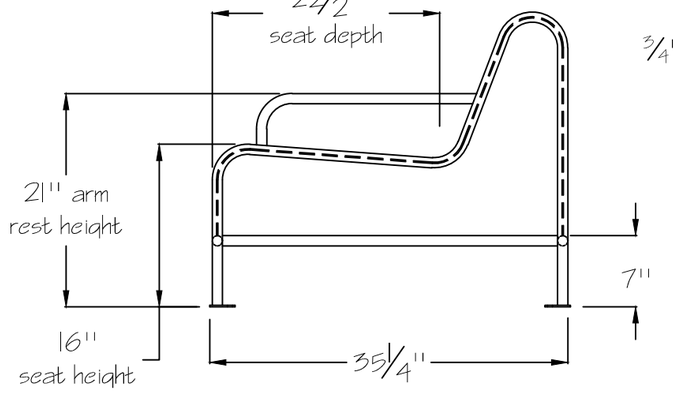

Front View

