RF-B-0506-ADPRINT · BENCHES

Bench 0506-ADPRINT



STANDARD CONFIGURATION

Dimensions configured to order.

MATERIALS & CONSTRUCTION

- Laser-cut and formed steel, fully welded.
- Fabricated under one roof in Roanoke, Virginia.
- Multi-stage marine-grade powder-coat finish.

BUILT TO ORDER

Every model is a starting point. Modify size, finish, mounting, and branding to suit the site.

CUSTOMIZE

Size	Lengths, depths, and back height built to the dimension you specify.
Finish	Any powder-coat color, standard or custom match.
Mounting	Surface, in-ground, or freestanding.
Branding	Laser-cut logos, plaques, and donor recognition integrated into the piece.

WARRANTY

Frame warranted against structural defect; powder-coat finish warranted against failure under normal public-realm use. Full terms on request.

(540) 342-1548 · info@rclfinc.com · Buy America (BABA)

Sales Order: 11808-L	Custom Picnic Table	
Item: SE-001	No. RF-B-0506-5-SM	
Finish: RAL 9011 Graphite Black	☐ approved	Date 5/11/21
Other: n/a	☐ approved as noted	By MBC
	☐ not approved revise as noted	Scale NTS

PHONE: 540.342.1548 FAX: 540.342.1417 WEB: RCLFINC.COM


RCLF SITE FURNISHINGS

Renaissance reserves the right to make adjustments during fabrication to ensure product integrity, performance, and meet applicable UL standards.


Renaissance recommends a "controlled climate" environment whenever prolonged storage is required. Failure to do so will void any / all expressed or implied warranties.

* revised seat height from 13-¾" to 16" per redline drawings_MC - 05.28.21

Top View

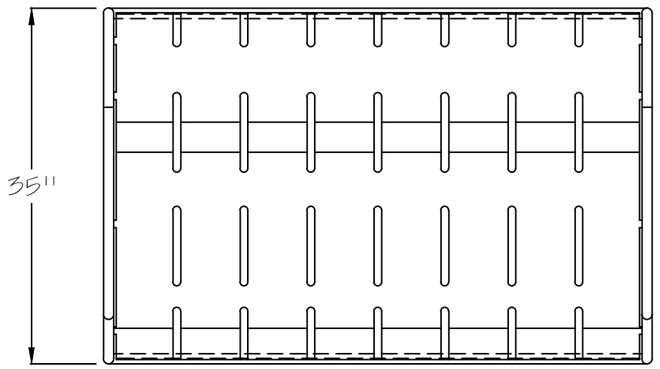


Front View

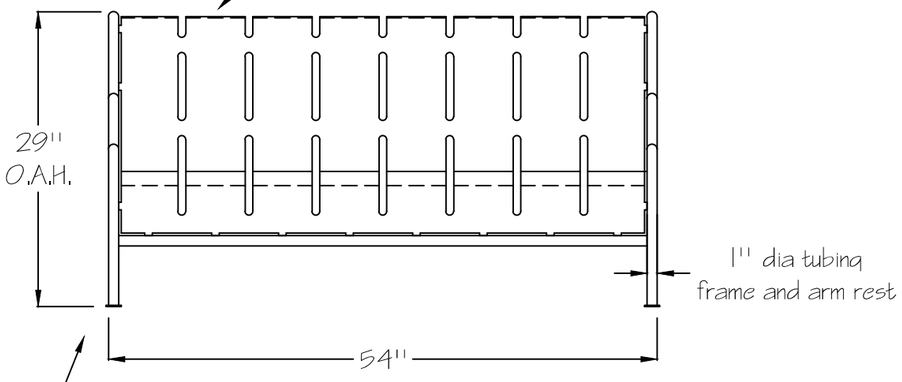

Seat slopes back at 4°
Seat depth deeper than standard depths based on inspiration picture. Customer / designer to confirm design and depth.

Side View

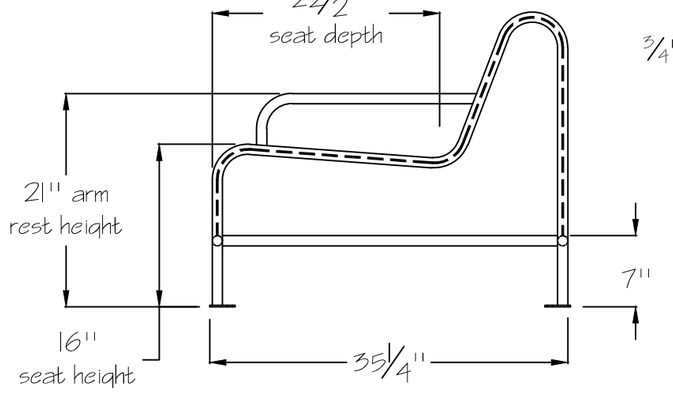

Front View

