RF-B-0507 · BENCHES

Bench

BUILT TO ORDER

Every model is a starting point. Modify size, finish, mounting, and branding to suit the site.

CUSTOMIZE

Size	Lengths, depths, and back height built to the dimension you specify.
Finish	Any powder-coat color - 33 standard options, plus custom match.
Mounting	Surface mount, Freestanding / portable.
Branding	Laser-cut logos, plaques, and donor recognition integrated into the piece.

STANDARD CONFIGURATION

Dimensions	Dimensions: | 193" OAL x 44" OAD x 35 3/8" OAH | Freestanding / portable
Finish	RAL 9011 Graphite Black Powder Coat

ANCHORING & ORDER CODES

Surface mount	**RF-B-0507-SM**
Freestanding / portable	**RF-B-0507-FS**

MATERIALS & CONSTRUCTION

- Laser-cut and formed steel, fully welded.
- Fabricated under one roof in Roanoke, Virginia.
- Multi-stage marine-grade powder-coat finish.

WARRANTY

Frame warranted against structural defect; powder-coat finish warranted against failure under normal public-realm use. Full terms on request.

POWDER-COAT FINISHES

33 standard colors · custom RAL match available

Black Peel	Black Texture	Cappuccino	Cargo Black	Chocolate Brown
Claret-Violet	Classic Grey	Cobalt Blue	Light Ivory	Fence Red
Fir Green	Green-Blue	Gun Metal	Glossy White	Lemon Yellow
Light Blue	Luna	Mineral Bronze	Nut Brown	Olive Patina
Oxblood	Pastel Turquoise	Poly Silver Vein	Red Letter	Rust
Silver Hammerstone	Safety Yellow	Star Dust	Sulfur Yellow	Traffic Gray
Verdi	Water Blue	White Peel		

Sales Order: 11808-L	Custom Curved Outdoor Bench	
Item: SE-002	No. RF-B-0507-16-SM-21A	
Finish: RAL 9011 Graphite Black	☐ approved	Date 5/11/21
Other: Toffee Faux Wood - Highwood	☐ approved as noted	By MCO
	☐ not approved revise as noted	Scale NTS

PHONE: 540.342.1548 FAX: 540.342.1417 WEB: RCLFINC.COM

RCLF SITE FURNISHINGS

Renaissance reserves the right to make adjustments during fabrication to ensure product integrity, performance, and meet applicable UL standards.

Renaissance recommends a "controlled climate" environment whenever prolonged storage is required. Failure to do so will void any / all expressed or implied warranties.

* added metal arm rests_MC - 06.01.21

Bench is KD in center for shipping

Top View

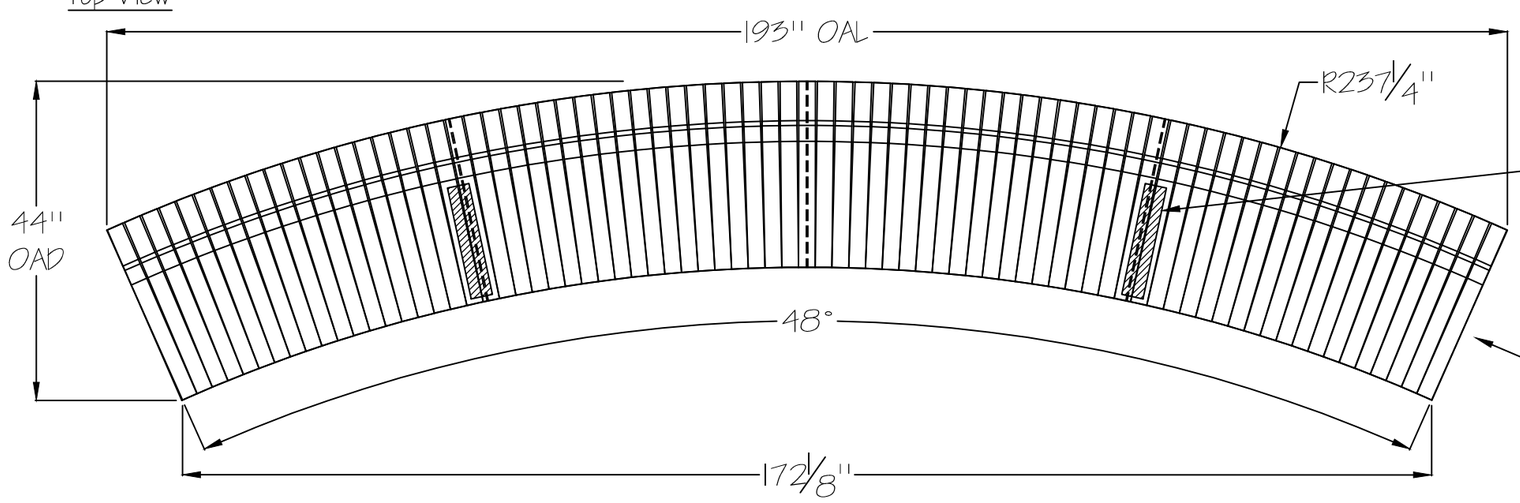

3/16" thick x 3" wide metal arm rests, typ x 2

Engineered poly faux wood slats secured to metal frame. Seat, Seat Back, Leg and Top slats secured from inside, no exposed hardware.

Front View

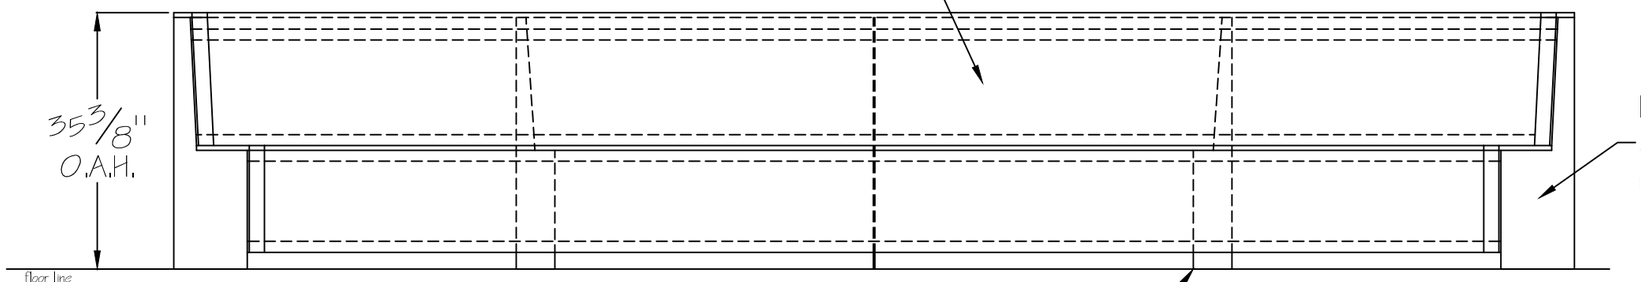

Engineered poly faux wood slats cover front and back of bench (not shown in this view)

laser cut mounting tabs with holes for 1/2" mounting hardware welded to 3/16" frames, accessible by temporarily removing slats on rear of bench (installation and hardware provided by others)

3/16" thick x 3" wide metal arm rests, typ x 2

3/16" thick laser cut frames with rolled 1-1/2" square tubing create frame and support for slats

laser cut frame ends are exposed, no slats

* 97° angled seat back
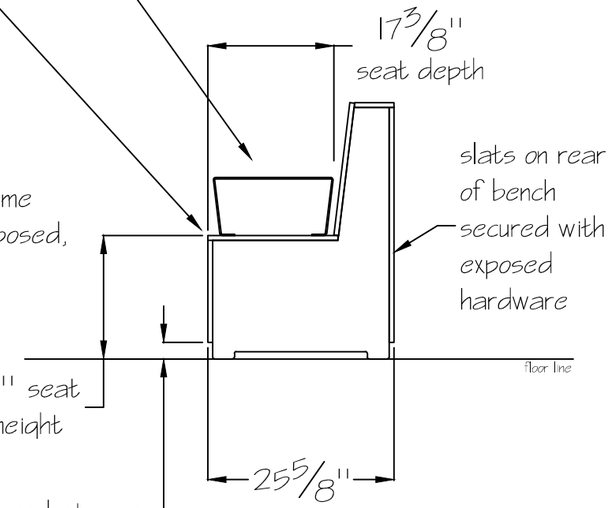
Side View