RF-G-0553 · BENCHES

Bench Swing



BUILT TO ORDER

Every model is a starting point. Modify size, finish, mounting, and branding to suit the site.

STANDARD CONFIGURATION

Dimensions configured to order.

MATERIALS & CONSTRUCTION

- Laser-cut and formed steel, fully welded.
- Fabricated under one roof in Roanoke, Virginia.
- Multi-stage marine-grade powder-coat finish.

CUSTOMIZE

Size	Lengths, depths, and back height built to the dimension you specify.
Finish	Any powder-coat color, standard or custom match.
Mounting	Surface, in-ground, or freestanding.
Branding	Laser-cut logos, plaques, and donor recognition integrated into the piece.

WARRANTY

Frame warranted against structural defect; powder-coat finish warranted against failure under normal public-realm use. Full terms on request.

(540) 342-1548 · info@rclfinc.com · Buy America (BABA)

Custom Bench Swing	date 1/4/22
RF-G-0553-48	scale N.T.S
☐ approved ☐ approved as noted ☐ not approved revise as noted	MCO

RCLF SITE FURNISHINGS

Sales Order: 12237-F


Item:

Finish: To be Approved

PHONE 540.342.1548 FAX 540.342.1417
WEB RCLFINC.COM


* added trim plates after discussion with customer_MC - 01.10.22

Top View

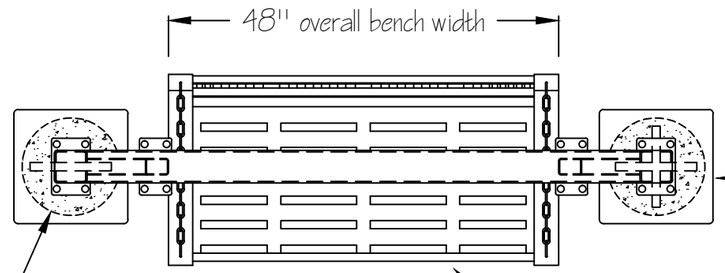


Trim plates discussed and designed to cover a 12" rnd or sq footer

3/16" thick bench bottom with laser cut slat pattern

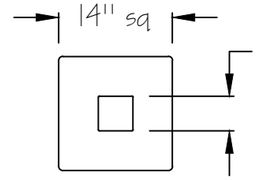

laser cut 1/8" thick single piece trim plates to cover footer areas after installation, typ x 2. Trim plates will need to be slid onto legs, secured near the top temporarily and then after installation adhered over footers. (inside edges wrapped with felt to protect against scratching legs during installation)

Front View

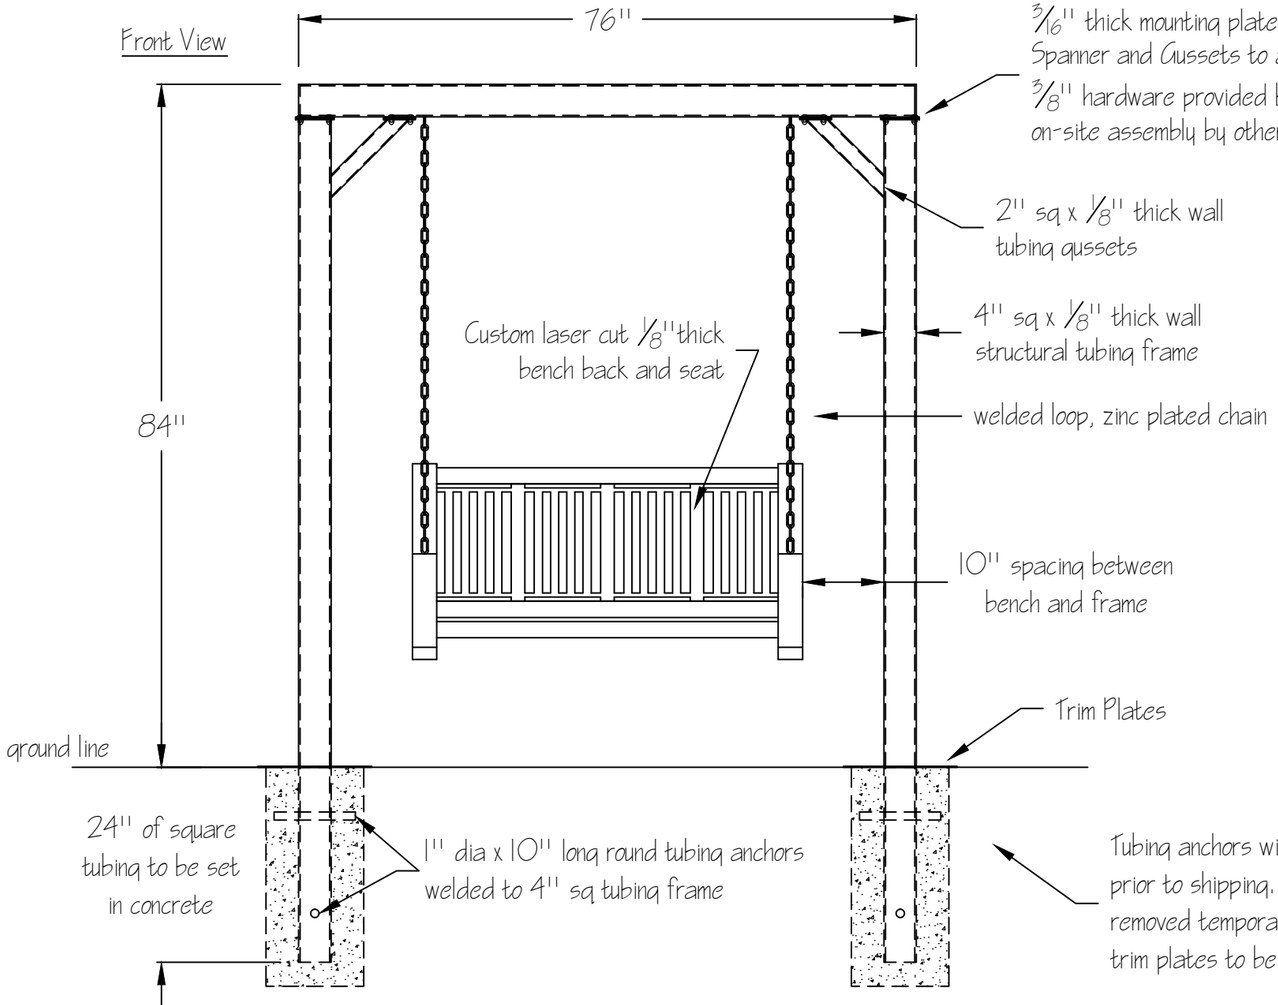

3/16" thick mounting plates welded to Uprights, Spanner and Gussets to allow for shipping. 3/8" hardware provided by Renaissance for on-site assembly by others.

2" sq x 1/8" thick wall tubing gussets

4" sq x 1/8" thick wall structural tubing frame


welded loop, zinc plated chain

10" spacing between bench and frame

Trim Plates

1" dia x 10" long round tubing anchors welded to 4" sq tubing frame

(installation and concrete provided by others)

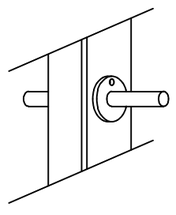

Tubing anchors will be bolted on at RCLF prior to shipping. On site these can then be removed temporarily allowing the single piece trim plates to be slid on to Legs before installation.

Side View

