TR-1954 · LITTER, RECYCLING & ASH

Mill Mountian Receptacle



BUILT TO ORDER

Every model is a starting point. Modify size, finish, mounting, and branding to suit the site.

CUSTOMIZE

Size	Lengths, depths, and back height built to the dimension you specify.
Finish	Any powder-coat color - 33 standard options, plus custom match.
Mounting	Surface mount, Freestanding / portable.
Branding	Laser-cut logos, plaques, and donor recognition integrated into the piece.

STANDARD CONFIGURATION

Dimensions configured to order.

MATERIALS & CONSTRUCTION

- Laser-cut and formed steel, fully welded.
- Fabricated under one roof in Roanoke, Virginia.
- Multi-stage marine-grade powder-coat finish.

ANCHORING & ORDER CODES

Surface mount	**TR-1954-SM**
Freestanding / portable	**TR-1954-FS**

WARRANTY

Frame warranted against structural defect; powder-coat finish warranted against failure under normal public-realm use. Full terms on request.

POWDER-COAT FINISHES

33 standard colors · custom RAL match available

Black Peel	Black Texture	Cappuccino	Cargo Black	Chocolate Brown
Claret-Violet	Classic Grey	Cobalt Blue	Light Ivory	Fence Red
Fir Green	Green-Blue	Gun Metal	Glossy White	Lemon Yellow
Light Blue	Luna	Mineral Bronze	Nut Brown	Olive Patina
Oxblood	Pastel Turquoise	Poly Silver Vein	Red Letter	Rust
Silver Hammerstone	Safety Yellow	Star Dust	Sulfur Yellow	Traffic Gray
Verdi	Water Blue	White Peel		


(540) 342-1548 · info@rclfinc.com · Buy America (BABA)

Sales Order: 7344-F	Custom Trash Receptacle	Date: 7.22.15
Item: Custom Trash Receptacle w/ DL-2 Lid	No. TR-1954-30-1G	Scale NTS
Finish: Fir Green Powder Coat & Recycled Plastic Slats	☐ approved ☐ approved as noted ☐ not approved revise as noted	
PHONE 540.342.1548 FAX 540.342.1417 WEB RCLFINC.COM		


RCLF SITE FURNISHINGS

* Corrected -DL2 to -RL Lid. MC 07.23.15

Top View

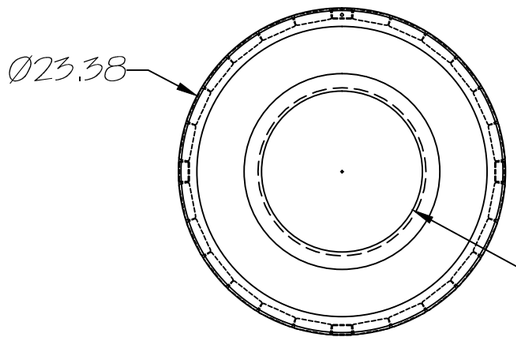

Front View

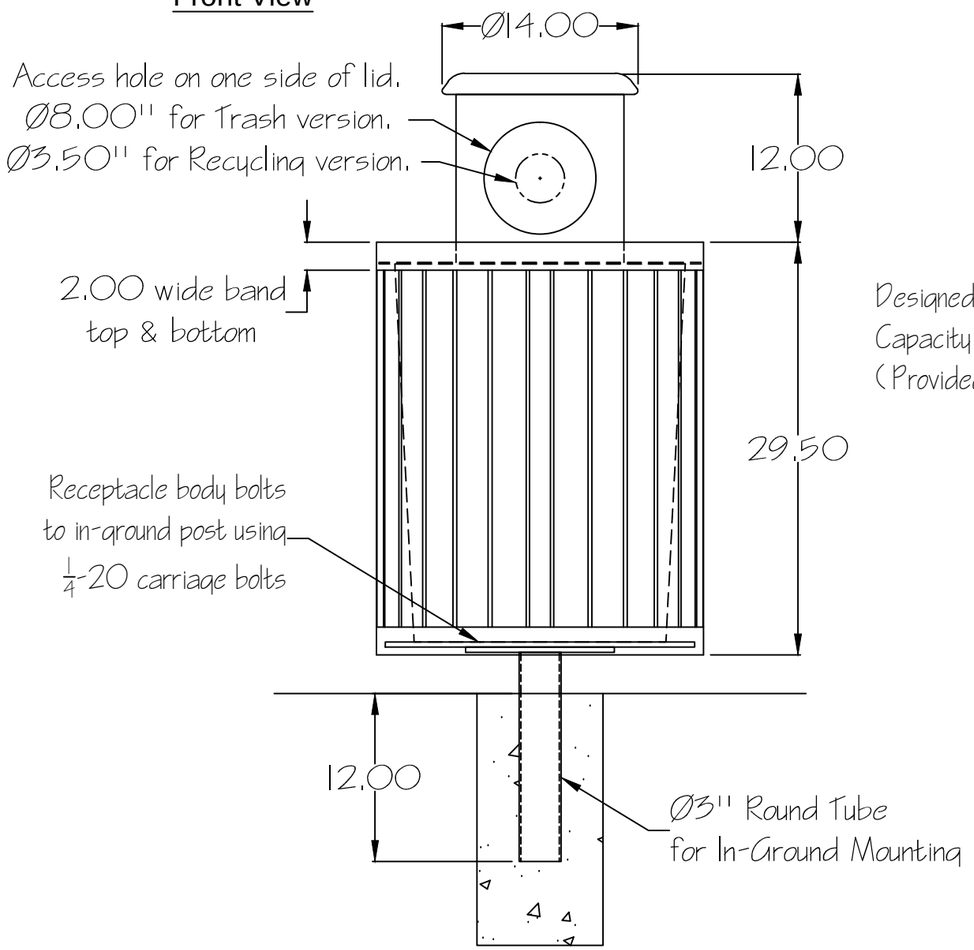

Side View

